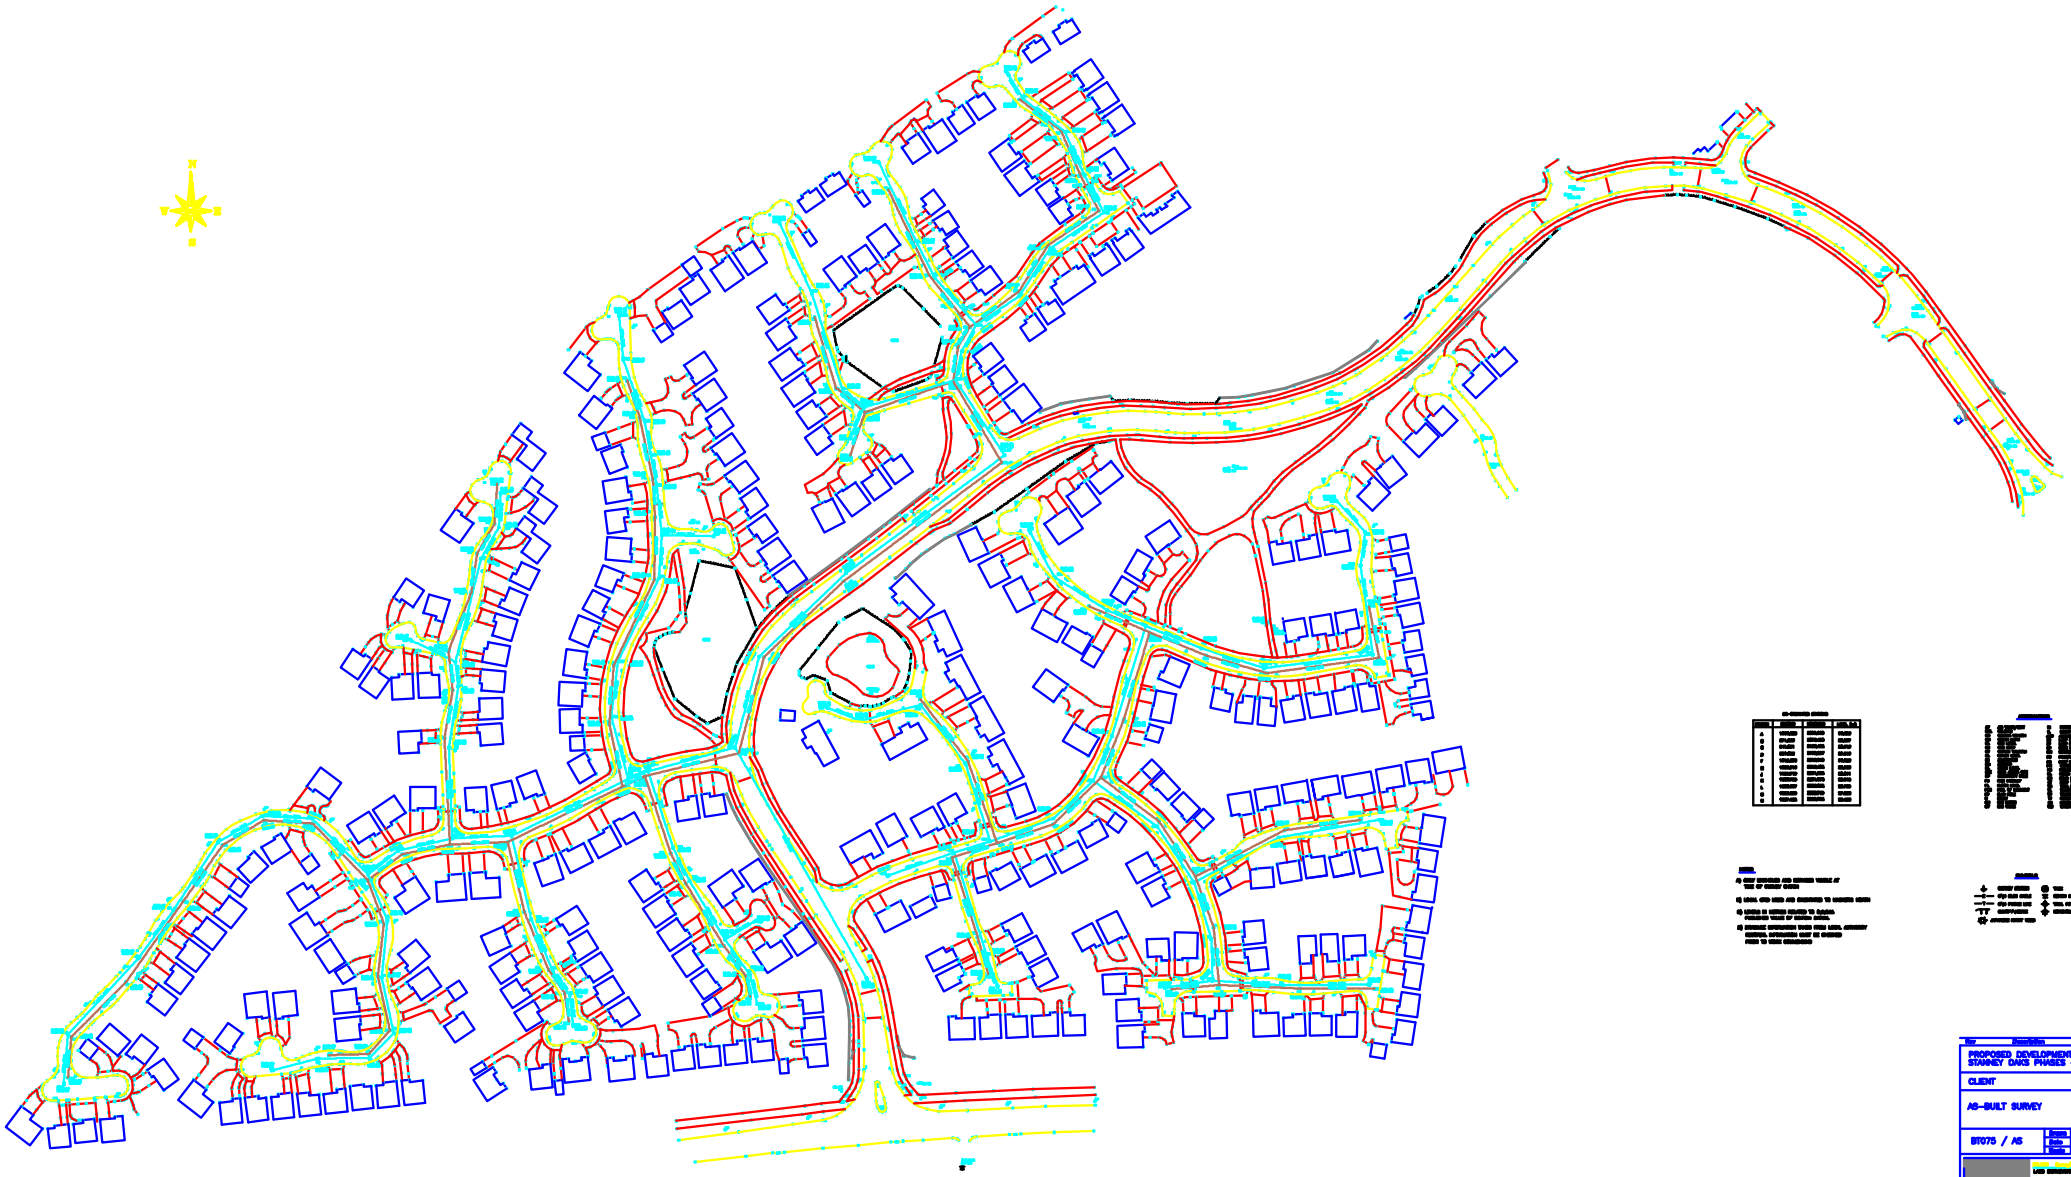

Rev	Description	Date

PROPOSED DEVELOPMENT AT STANNEY DAIS PHASES 4, 5, 6.

CLIENT

AS-BUILT SURVEY

87075 / AS	Drawn : S. BURGESS Date : APRIL 2009 Scale : 1:2500

RJP